


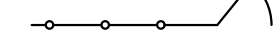

LEGEND

-  CHAINLINK FENCE AND GATE
-  CONCRETE PAVEMENT
-  BASKETBALL SURFACING

NOTES

1. SEE CIVIL LAYOUT DRAWINGS FOR COORDINATION OF WORK WITH GENERAL LAYOUT, PAVING, UTILITIES AND ALL OTHER CONDITIONS ADJACENT TO PLAYING FIELDS.
2. VERIFY ALL SITE CONDITIONS AND DIMENSIONS SHOWN ON THE PLANS PRIOR TO COMMENCEMENT OF WORK. NOTIFY OWNER AND ITS REPRESENTATIVES OF ANY DISCREPANCIES OR IRREGULAR CONDITIONS.
3. SEE SHEETS SR-201 FOR COURT GRADING AND DRAINAGE PLANS.
4. THE CONTRACTOR SHALL BE RESPONSIBLE FOR PROVIDING ALL FIELD LAYOUT. THE CONTRACTOR SHALL TAKE TIES TO ALL UTILITY CONNECTIONS AND PROVIDE MARKED-UP RECORD PLANS FOR ALL UTILITIES INSTALLED OR ENCOUNTERED PER SPECIFICATIONS.
5. ALL ANGLES ARE 90° UNLESS OTHERWISE INDICATED.
6. THE CONTRACTOR SHALL SUBMIT SHOP DRAWINGS SHOWING ALL ELEMENTS AS REQUIRED IN THE SPECIFICATIONS.
7. DIMENSIONS SHOWN ARE TO CENTERLINE OF CHAIN LINK FENCE, WHERE APPLICABLE.

IT IS A VIOLATION OF LAW FOR ANY PERSON UNLESS THEY ARE ACTIVE UNDER THE SUPERVISION OF A LICENSED PROFESSIONAL ENGINEER, ARCHITECT, LANDSCAPE ARCHITECT OR LAND SURVEYOR TO ALTER AN ITEM IN ANY MANNER IF AN ITEM BEARING THE STAMP OF A LICENSED PROFESSIONAL IS ALTERED. THE ALTERING ENGINEER, ARCHITECT, LANDSCAPE ARCHITECT OR LAND SURVEYOR SHALL STAMP THE DOCUMENT AND INCLUDE THE NOTATION "ALTERED BY" FOLLOWED BY THEIR SIGNATURE, THE DATE OF SUCH ALTERATION, AND A SPECIFIC DESCRIPTION OF THE ALTERATION.


**MIDCOAST ATHLETIC & RECREATION COMPLEX
 PHASE 1- TIER 1C**
 220 NEPTUNE DRIVE
 BRUNSWICK, ME 04011

No.	Submittal / Revision	App'd.	By	Date


SITE LAYOUT PLAN


Designed By:	Drawn By:	Checked By:
JKM	JKM	JP
Issue Date:	Project No.:	Scale:
09/18/25	075393	AS SHOWN

Drawing No.:
C-101

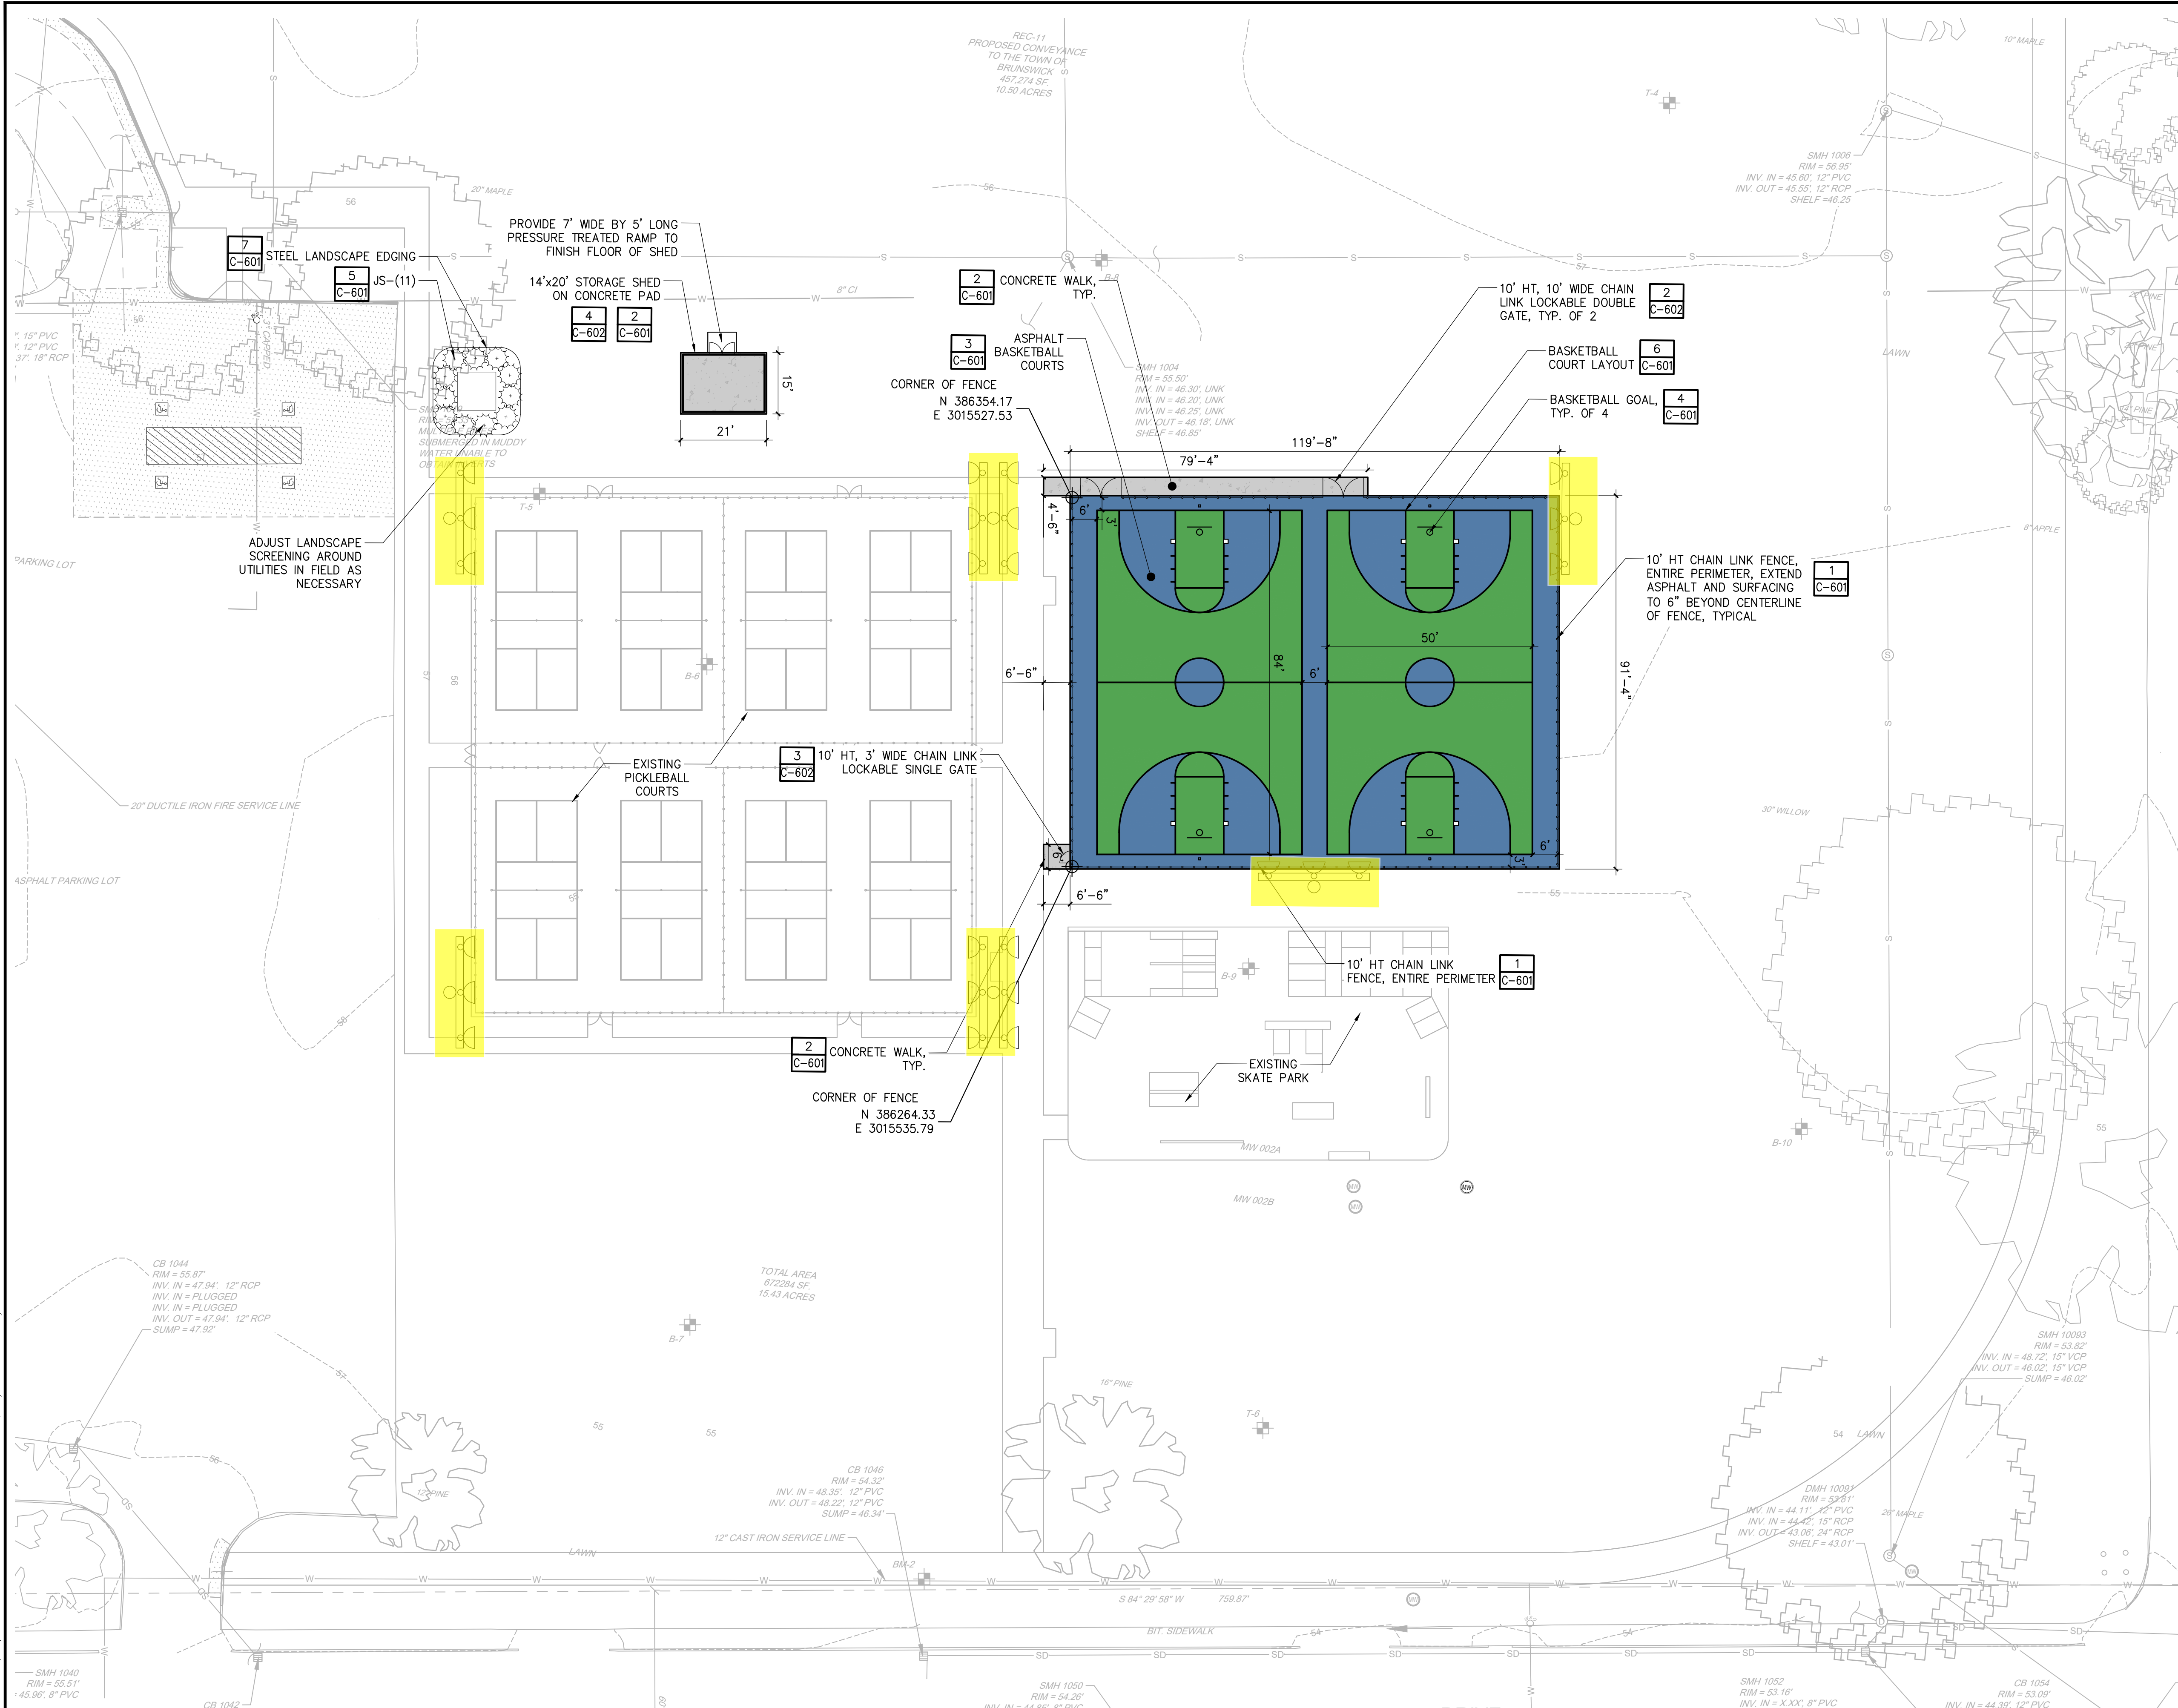

PLANT SCHEDULE

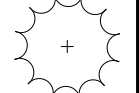EVERGREEN SHRUBS		BOTANICAL NAME	COMMON NAME	CALIPER	SPREAD	MINIMUM HEIGHT	BALL DIA.	POT SIZE	QTY.
SYMBOL	ABBR.								
	JS	JUNIPERUS SCOPULORUM WICHITA BLUE	WICHITA BLUE JUNIPER			4'-6"			11

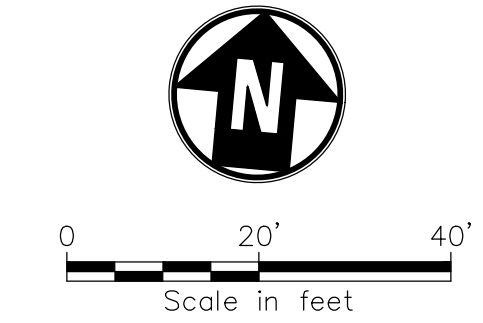

File: V:\PROJECTS\161075393\000\09_DESIGN\DRAWINGS\01_SHEETS\SR-101-075393-CD-1B.DWG
 Saved: 9/23/2025 4:39:00 PM. Picked: 9/26/2025 8:33:20 AM. Current User: Merklein, Jayme. Last Saved By: 8018